


ASBUILT
13291 VANTAGE
WAY
JAX, FL

DATE: DECEMBER 7, 2021

REVISIONS:

ASBUILT

A105
SUITE 105

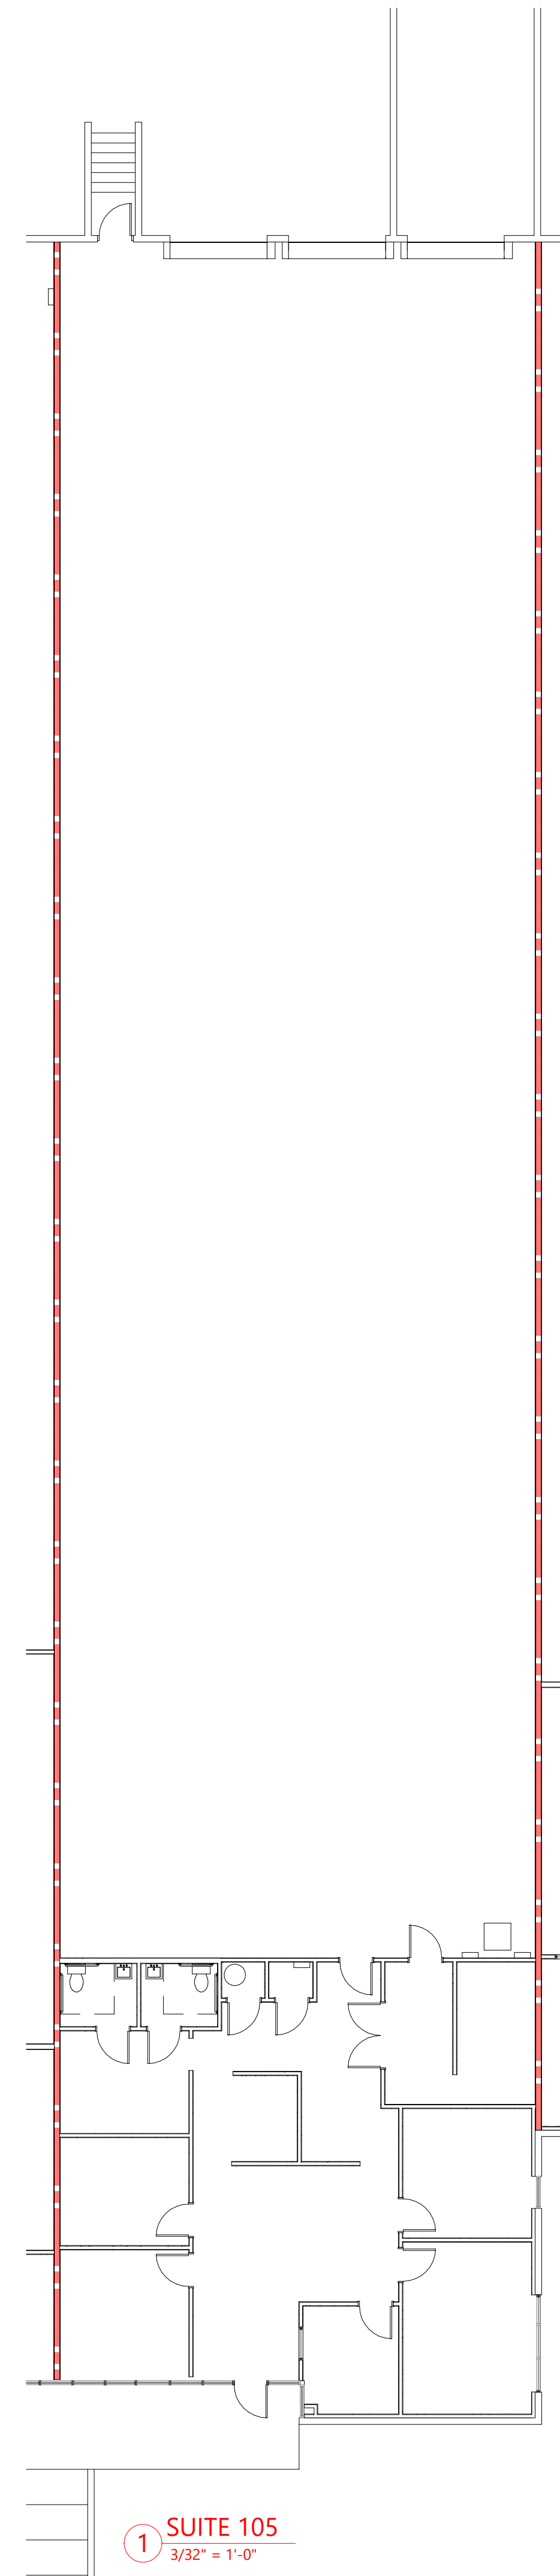

① SUITE 105
3/32" = 1'-0"

ALL REPORTS, SPECIFICATIONS, COMPUTER FILES, FIELD DATA AND OTHER DOCUMENTATION PREPARED BY NEW DAY DESIGN COMPANY, LLC AS INSTRUMENTS OF SERVICE SHALL REMAIN THE PROPERTY OF NEW DAY DESIGN COMPANY, LLC. NEW DAY DESIGN COMPANY, LLC SHALL RETAIN ALL COMMERCIAL, STATUTORY AND OTHER RESERVED RIGHTS, INCLUDING THE COPYRIGHT THEREIN. THIS DRAWING SHALL NEVER BE REPRODUCED IN WHOLE OR IN PART WITHOUT THE EXPRESS WRITTEN PERMISSION OF NEW DAY DESIGN COMPANY, LLC.